


EXECUTIVE NORTH OFFICE PARK

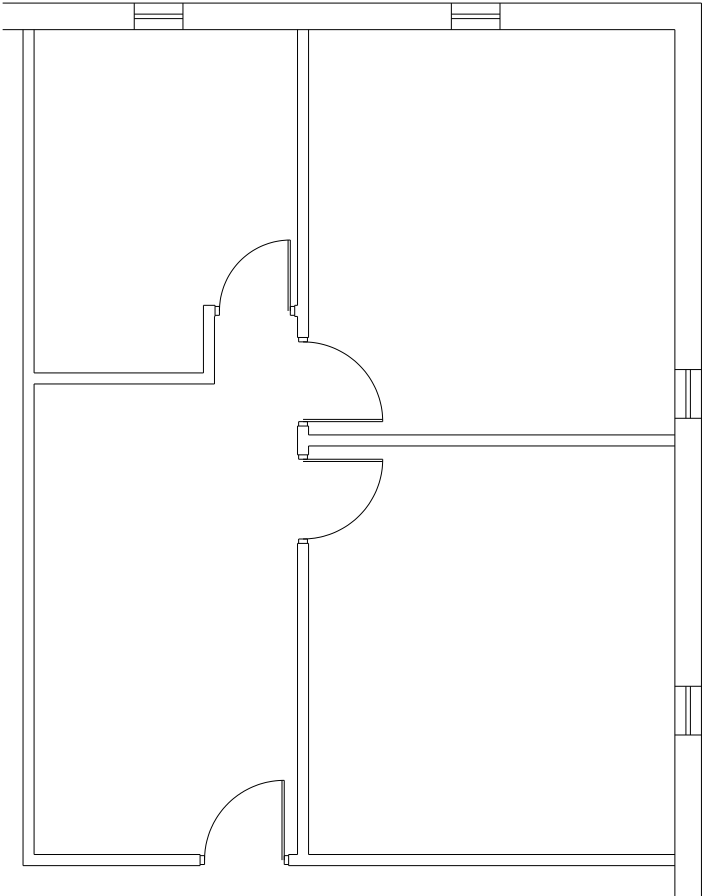

931 E. 86TH STREET  
SUITE 111  
"AS BUILT"