


EXCUTIVE NORTH OFFICE PARK

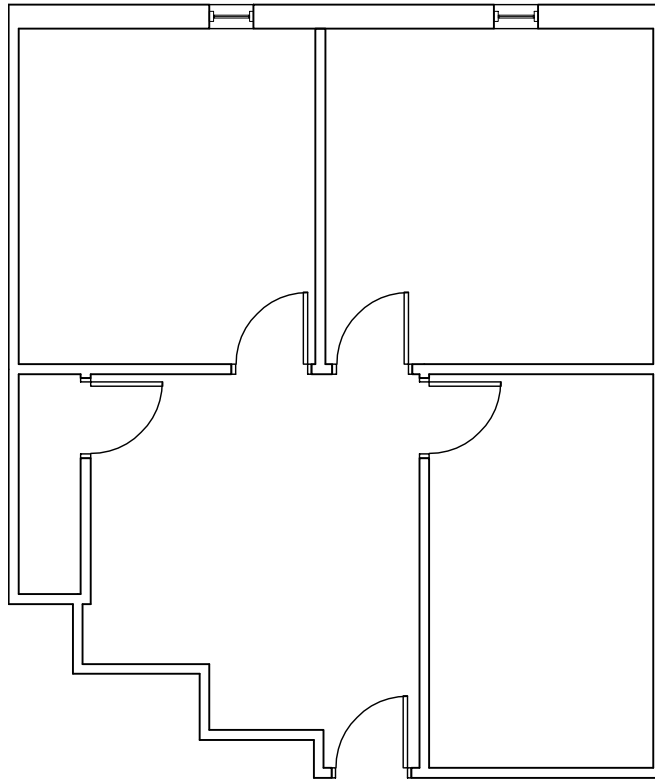

921 E. 86TH STREET  
SUITE 203  
'AS-BUILT'