


EXECUTIVE NORTH OFFICE PARK

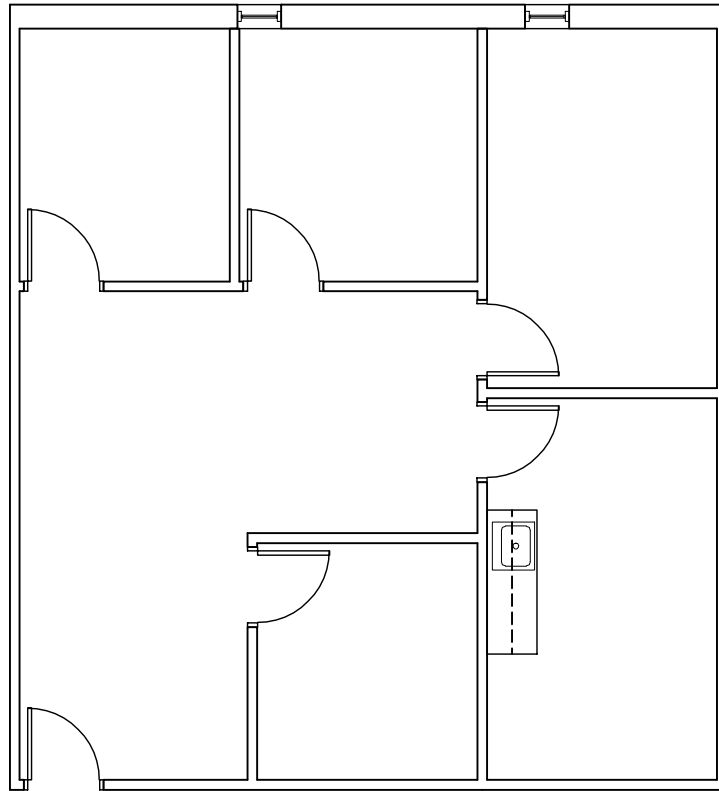

941 E. 86TH STREET
SUITE 270
"AS-BUILT"