


EXECUTIVE NORTH OFFICE PARK

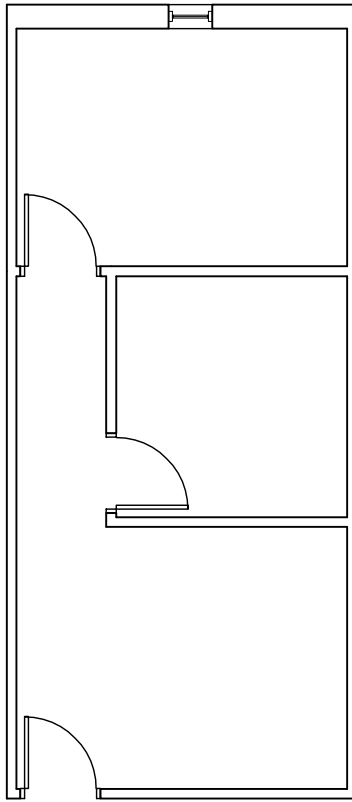

931 E. 86TH STREET  
SUITE 107  
'AS-BUILT'